


VECTORWORKS EDUCATIONAL VERSION

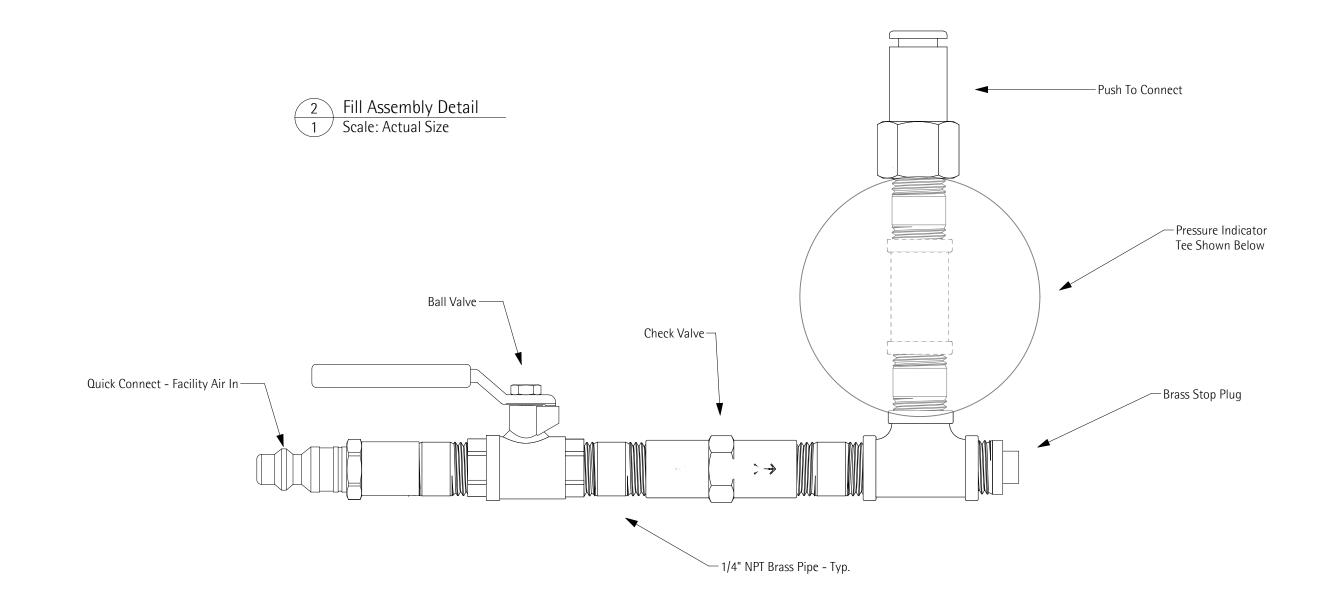

1 Pneumatics Hookup Diagram 1 Scale: Not To Scale

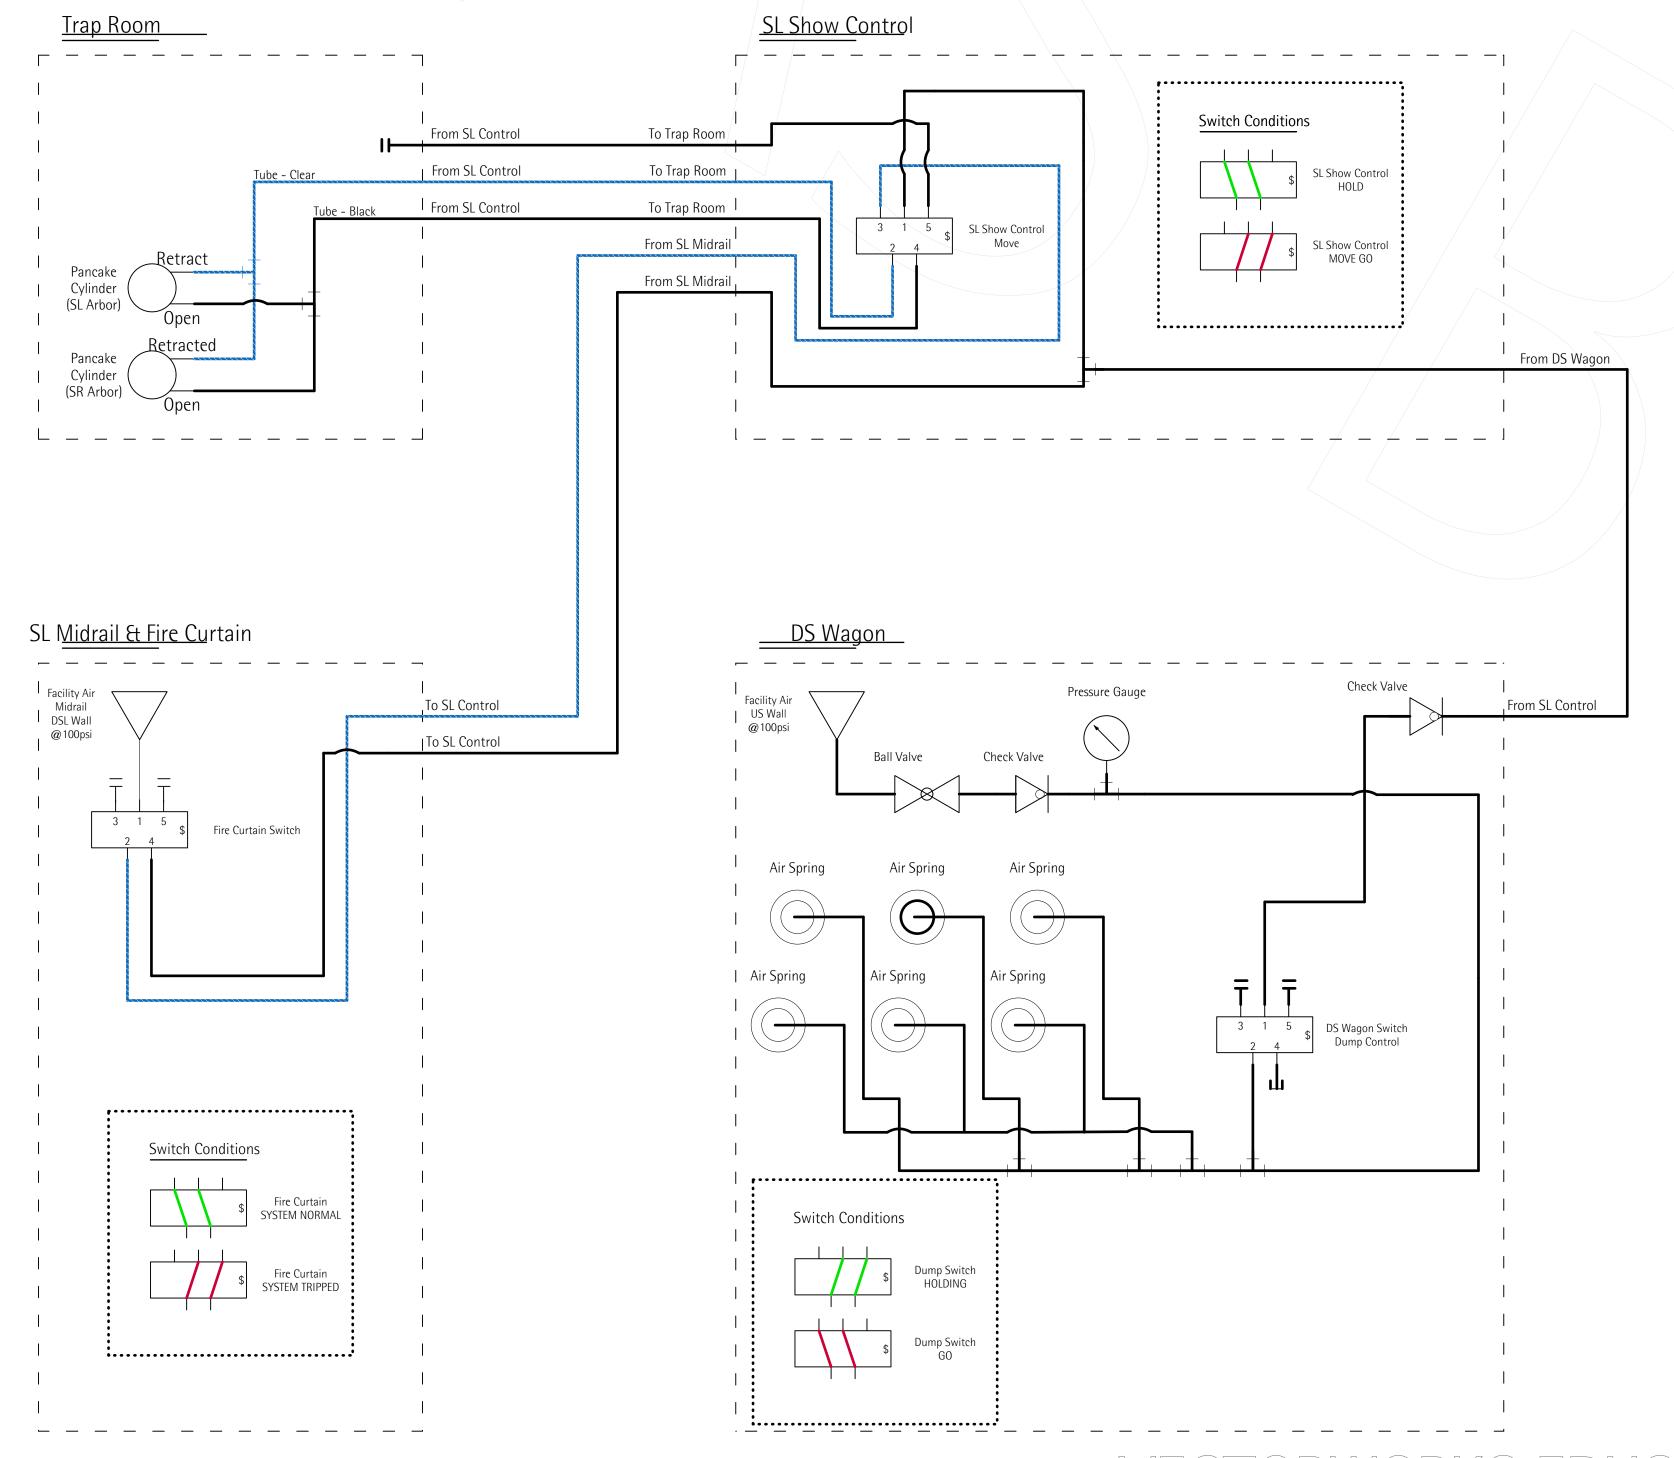

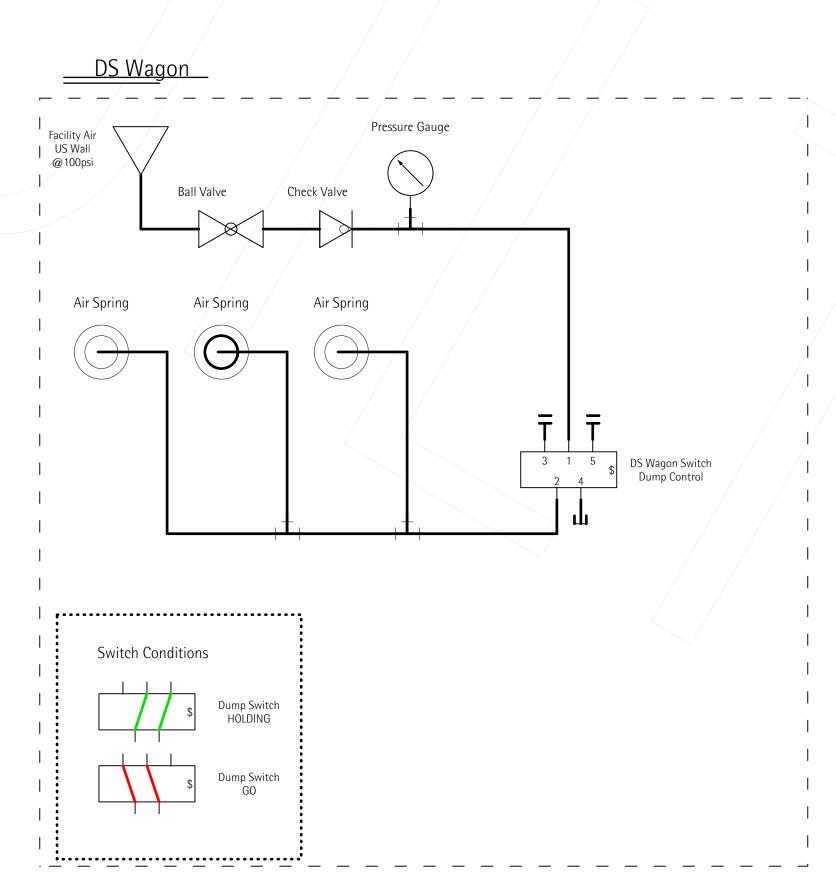

<u>Legend</u>					
T Open					
+ Tee					
Нор					
Black Line					
Clear Line					

The Crucible				Approved By:	A Piga
Scenic Unit				1	
Raked Deck Unit					5
Plate Title				1	[5
Wagon Pnuematics	Diagram - AS BUILT				3
Designer	Scale	Date	Sheet	1	<u> </u>
Jared Gerbig	Not To Scale	9/15/2013	1 1 /		<u>.</u> 9
Project Manager	Lead	Draft	□ '/		15
Foco	n'Kaafa	Meyer	1 / 1	D .	ے ا

/ECTORWORKS EDUCATIONAL VERSION